


MUNICIPALIDAD DE CORDOBA

RS 554-T/2016

Direccion de Redes Sanitarias y Gas

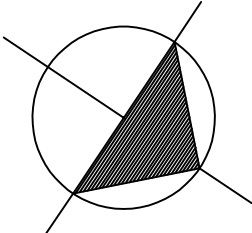

Calle :Pública Nº 11 de calle Pública 5 a Pública Nº 7

Colectora P.V.C. Ø 160 mm

Nº de Conexiones : 12

BR 35 a BR 49 Ø 160 Lc= 35.00 m p=4.0 ‰
BR 49 a BR 50 Ø 160 Lc= 83.00 m p=4.7 ‰
BR 50 a BR 15 Ø 160 Lc= 82.00 m p=8.2 ‰

Contratista: Hidromat S.A.

| | | | | | | | | | | | | | | | | |
|---------------------|--|--------|-------|--------|--------|------|-------|-------|-------|-------|--------|-------|-------|-------|--------|------|
| PROF. BAJO VEREDA | | 1.15 | 1.10 | 1.10 | 1.30 | 1.10 | 1.10 | 1.10 | 1.10 | 1.10 | 0.80 | 1.10 | 1.10 | 1.10 | 1.10 | 0.95 |
| COTA DE TERRENO | | 450.28 | | 450.53 | 450.53 | | | | | | 450.72 | | | | 452.20 | |
| COTA COLECTORA | | 449.38 | | 449.53 | 449.53 | | | | | | 449.92 | | | | 450.20 | |
| DISTANCIA A B.R. | | 0.00 | 21.39 | 33.40 | 0.00 | 5.02 | 20.04 | 35.11 | 50.04 | 64.90 | 76.43 | 60.95 | 45.67 | 30.09 | 14.09 | 0.00 |
| DIST.-ZONA - MANZ. | | | | | | | | | | | | | | | | |
| DIST. CONEX. A MED. | | | | | | | | | | | | | | | | |
| ANCHO DE PARCELA | | | | | | | | | | | | | | | | |
| N* DE PROP./PARCELA | | | | | | | | | | | | | | | | |

CALLE PUBLICA 5

CALLE PUBLICA 7

Dist. 30 - Zona 19 Manz. 127

C.Pública 11

BR 35

BR 49

BR 50

BR 15

BR 15 bis

ARROYO LA CAÑADA

ESPACIO VERDE

| | |
|---------------------|---------------------|
| N* DE PROP./PARCELA | RS 554T/16 Ø 355 mm |
| ANCHO DE PARCELA | |
| DIST. CONEX. A MED. | |
| DIST.-ZONA - MANZ. | |
| DISTANCIA A B.R. | |
| COTA COLECTORA | |
| COTA DE TERRENO | |
| PROF. BAJO VEREDA | |