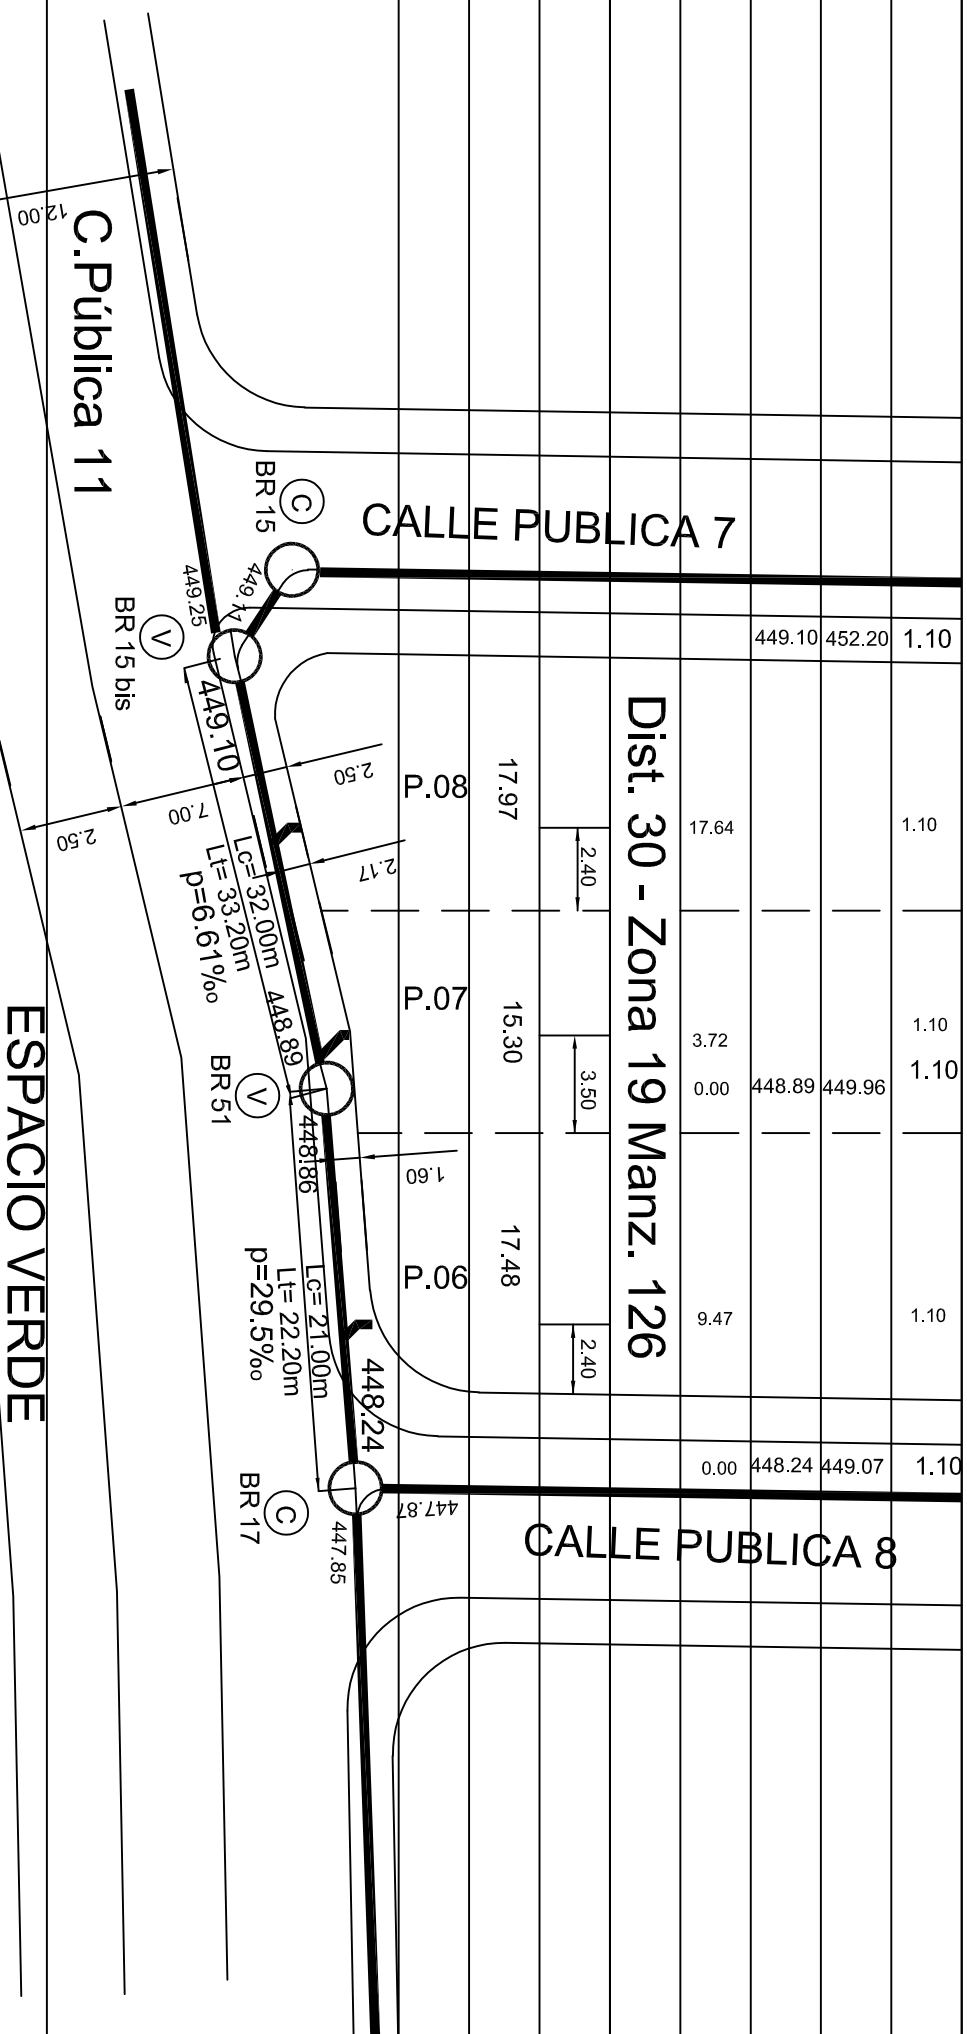


BR 15 bis a BRE 51 Ø 160 Lc= 32.00 m p=6.60%

BR 51 a BRE 17 Ø 160 Lc= 21.00 m p=29.5%

Nº de Conexiones : 3

[illegible]

|                     |  |
|---------------------|--|
| N° DE PROP./PARCELA |  |
| ANCHO DE PARCELA    |  |
| DIST. CONEX. A MED. |  |
| DIST.-ZONA - MANZ.  |  |
| DISTANCIA A B.R.    |  |
| COTA COLECTORA      |  |
| COTA DE TERRENO     |  |
| PROF. BAJO VEREDA   |  |